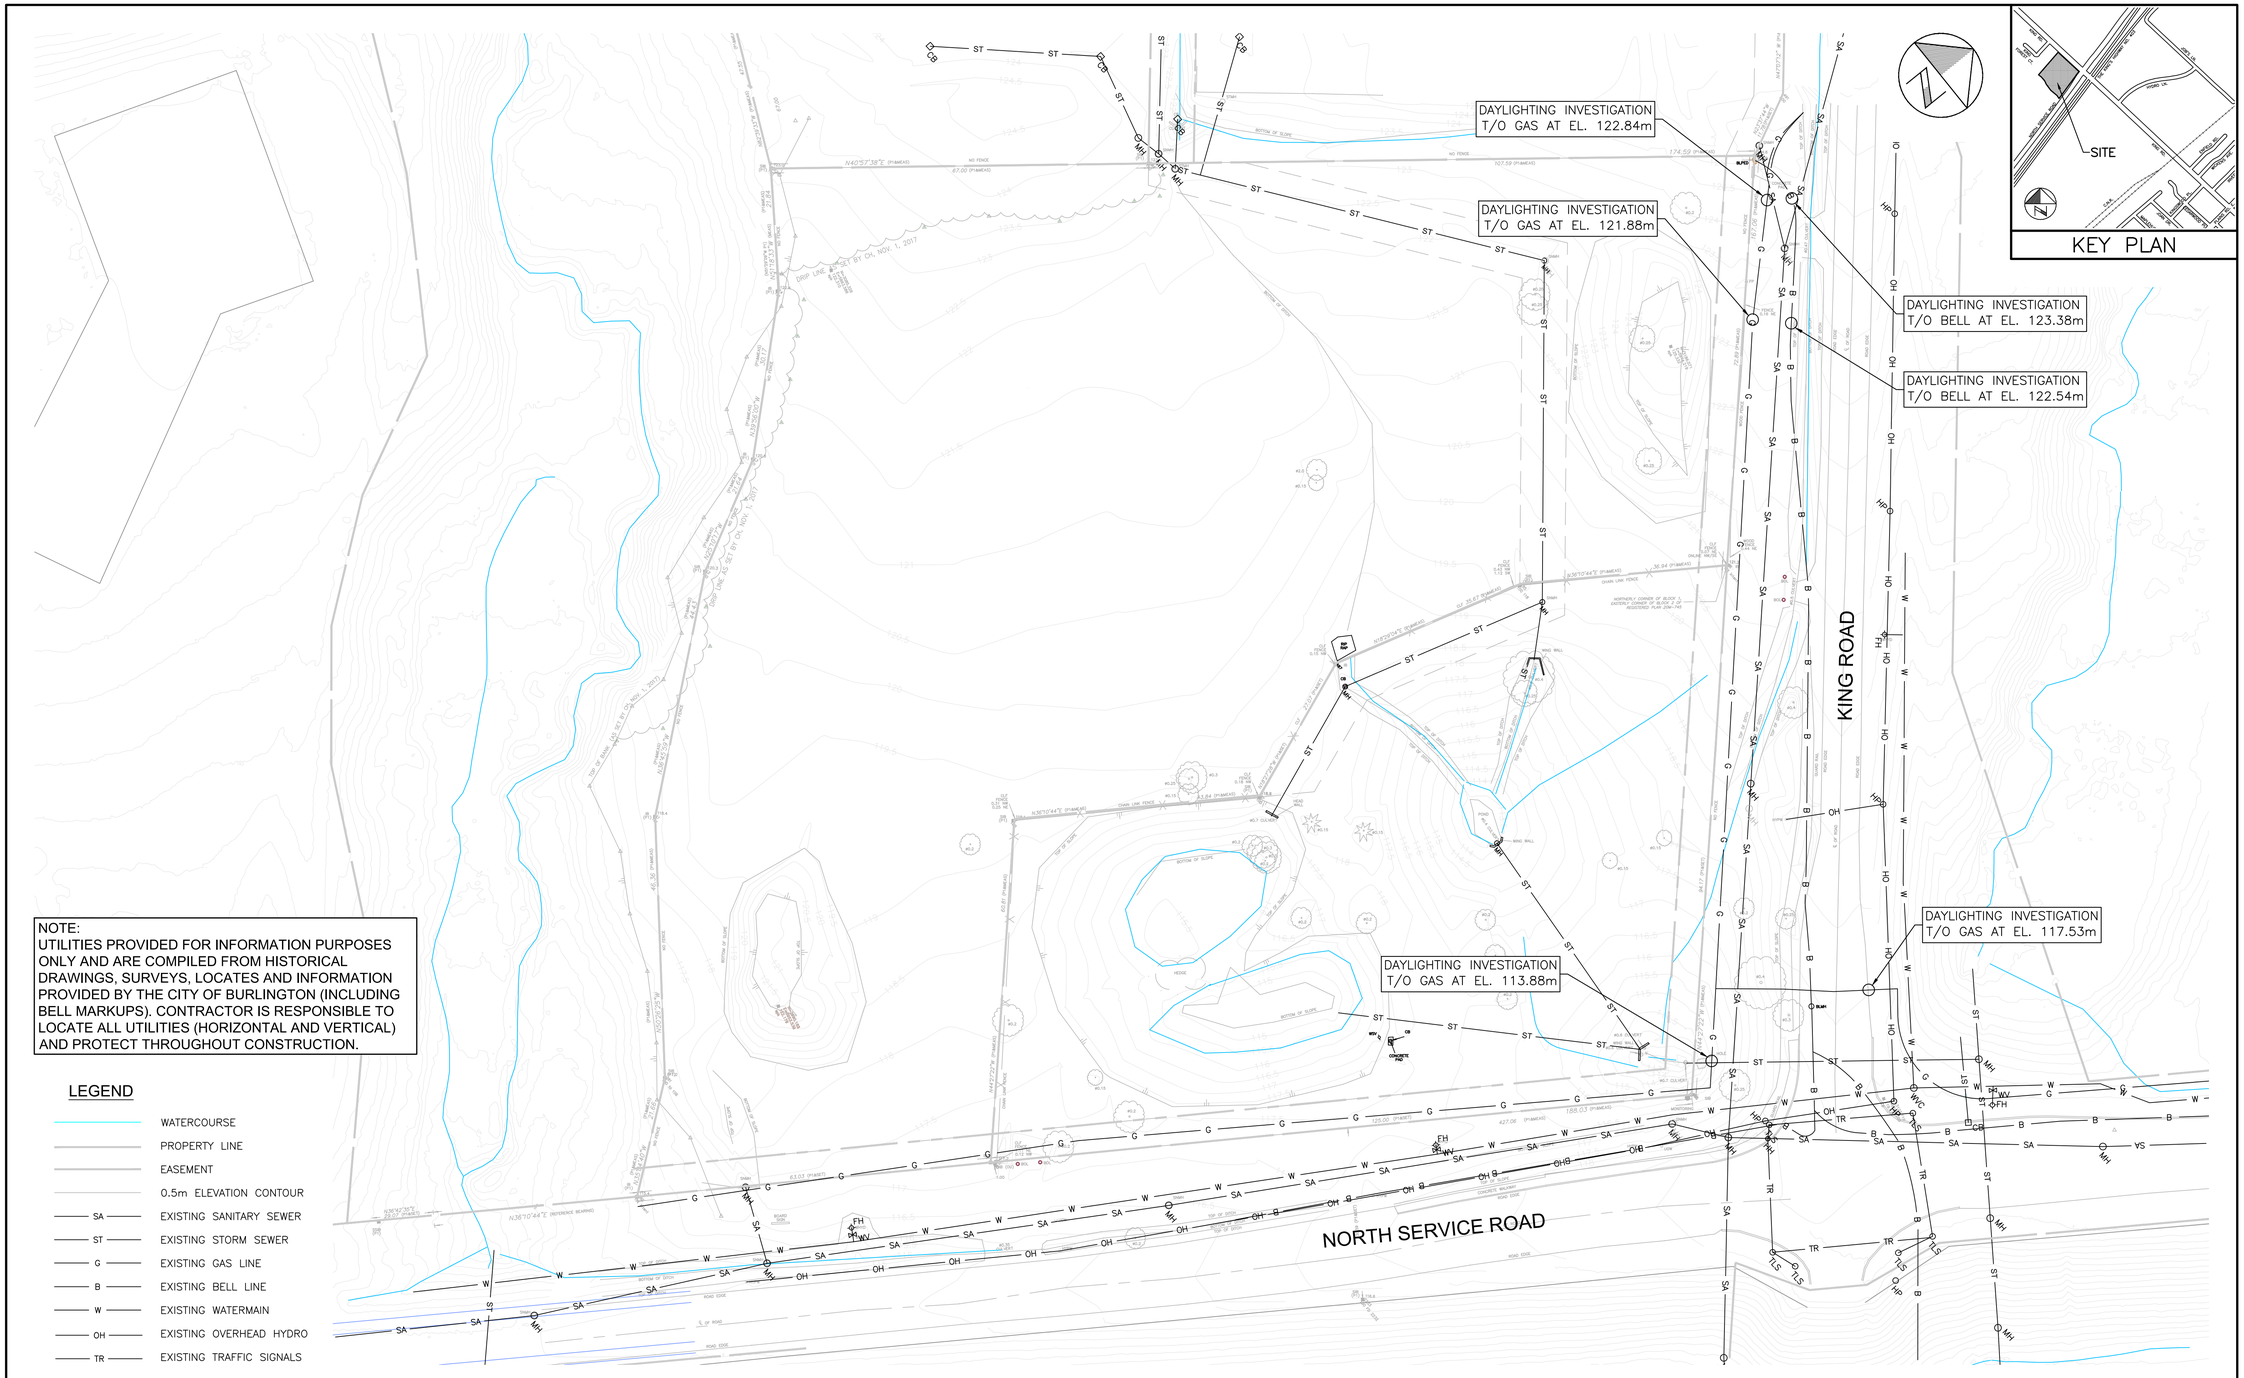


NOTE:
UTILITIES PROVIDED FOR INFORMATION PURPOSES ONLY AND ARE COMPILED FROM HISTORICAL DRAWINGS, SURVEYS, LOCATES AND INFORMATION PROVIDED BY THE CITY OF BURLINGTON (INCLUDING BELL MARKUPS). CONTRACTOR IS RESPONSIBLE TO LOCATE ALL UTILITIES (HORIZONTAL AND VERTICAL) AND PROTECT THROUGHOUT CONSTRUCTION.

LEGEND

- WATERCOURSE
- PROPERTY LINE
- EASEMENT
- 0.5m ELEVATION CONTOUR
- SA — EXISTING SANITARY SEWER
- ST — EXISTING STORM SEWER
- G — EXISTING GAS LINE
- B — EXISTING BELL LINE
- W — EXISTING WATERMAIN
- OH — EXISTING OVERHEAD HYDRO
- TR — EXISTING TRAFFIC SIGNALS

Plotted: 2024-05-28
Last Saved: 2024-05-28
Plotted By: wds_richard.bartolo
Last Saved By: wds_richard.bartolo
Path: D:\PROJECT\2021\WW21012079 - Quantum\14 CAD\WR\PROJECTS\2023-04 (Update)\Dwg 2 - Utilities.dwg

No	Date	Drawn	Appr'd	Revisions
3	24-05-28	RMB	MJS	REVISE EXISTING UTILITIES
2	23-05-02	RMB	MJS	ISSUED FOR SPA SUBMISSION
1	22-01-14	MBK	MJS	INITIAL SPA SUBMISSION

APPROVALS

NOT TO BE USED FOR CONSTRUCTION

Design	MS	Checked	RBS
Drawn	MBK	Checked	MS
Scale	1:500 (0 5 10 20)		
Date	JANUARY 2022		

LICENSED PROFESSIONAL ENGINEER
M. J. SENIOR
100116557
PROVINCE OF ONTARIO
5/28/2024

1450 KING ROAD
ASTRA REALTY MANAGEMENT INCORPORATED

UTILITIES COORDINATION PLAN

wsp

Contract No.
Consultant File No. WW21012079
Drawing No.
SHEET 2 OF 14