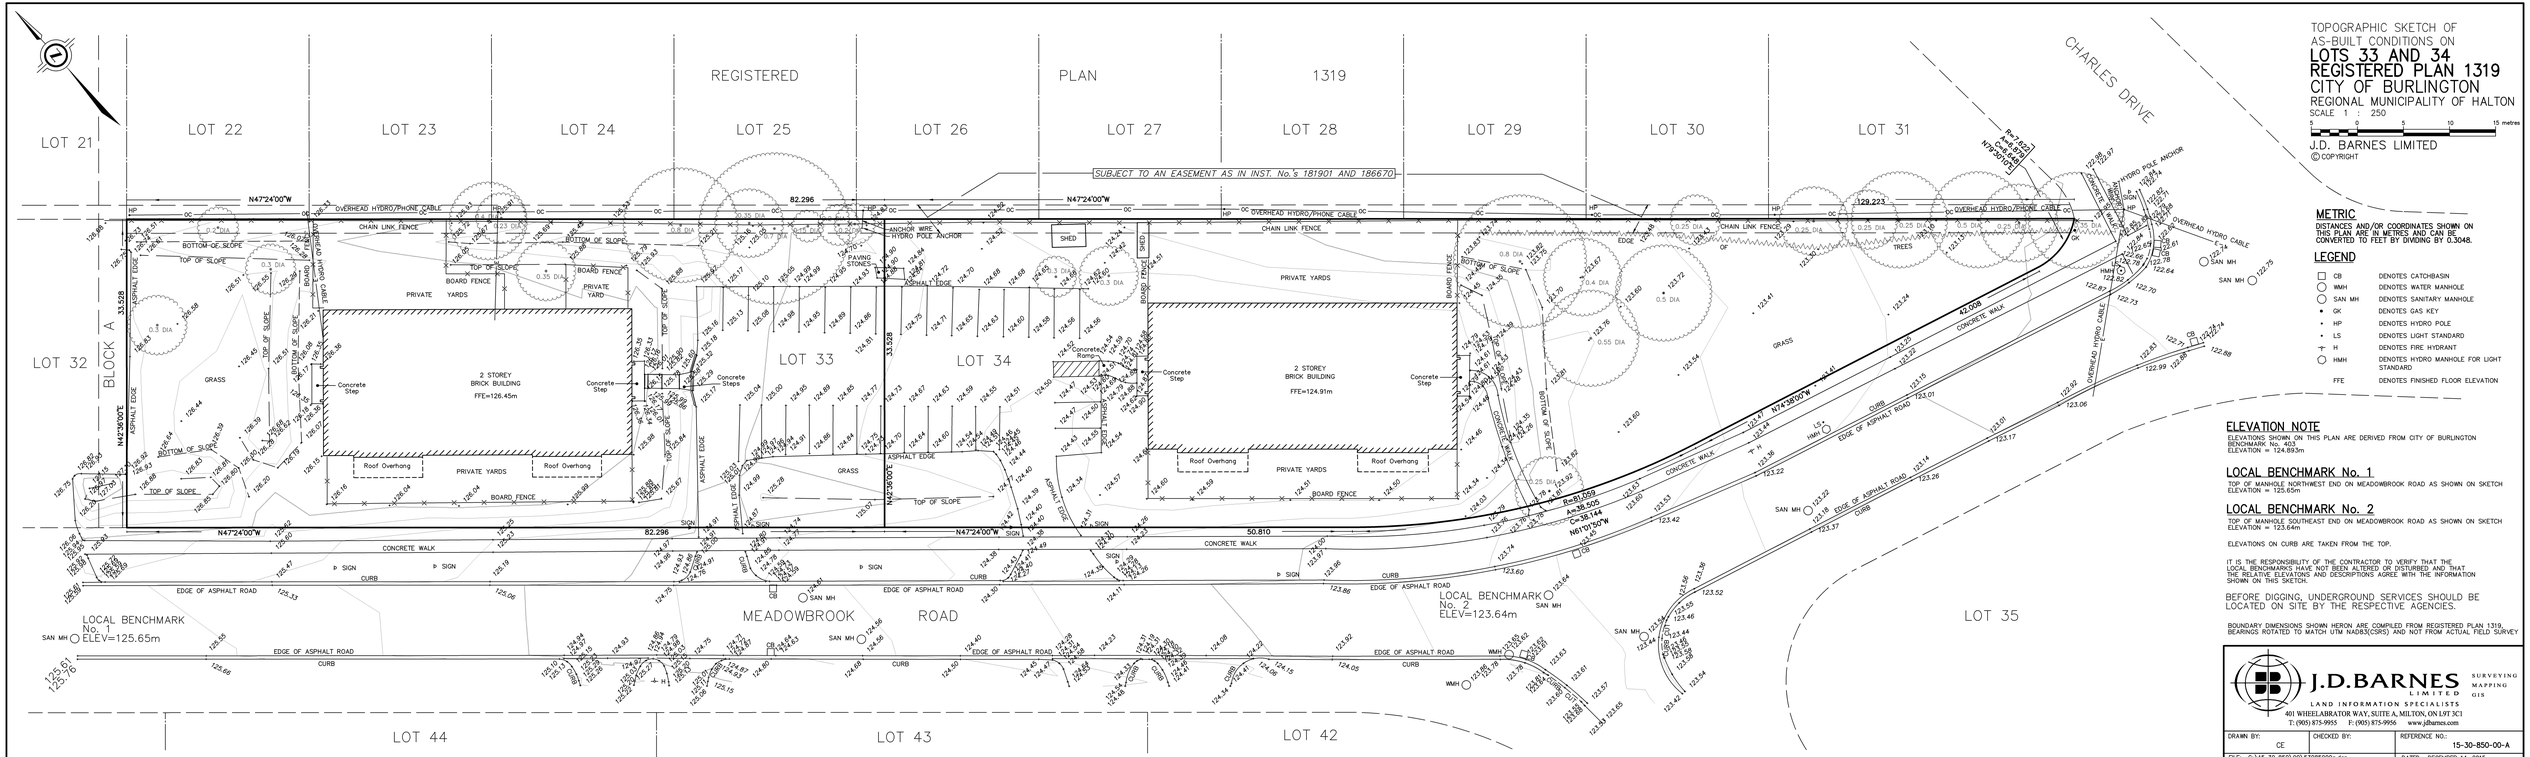


TOPOGRAPHIC SKETCH OF AS-BUILT CONDITIONS ON

LOTS 33 AND 34 REGISTERED PLAN 1319

CITY OF BURLINGTON

REGIONAL MUNICIPALITY OF HALTON

SCALE 1 : 250

5 0 5 10 15 metres

J.D. BARNES LIMITED
© COPYRIGHT

METRIC

DISTANCES AND/OR COORDINATES SHOWN ON THIS PLAN ARE IN METRES AND CAN BE CONVERTED TO FEET BY DIVIDING BY 0.3048.

LEGEND

CB	DENOTES CATCHBASIN
WMH	DENOTES WATER MANHOLE
SAN MH	DENOTES SANITARY MANHOLE
GK	DENOTES GAS KEY
HP	DENOTES HYDRO POLE
LS	DENOTES LIGHT STANDARD
H	DENOTES FIRE HYDRANT
HMH	DENOTES HYDRO MANHOLE FOR LIGHT STANDARD
FFE	DENOTES FINISHED FLOOR ELEVATION

ELEVATION NOTE

ELEVATIONS SHOWN ON THIS PLAN ARE DERIVED FROM CITY OF BURLINGTON BENCHMARK No. 403
ELEVATION = 124.893m

LOCAL BENCHMARK No. 1

TOP OF MANHOLE NORTHWEST END ON MEADOWBROOK ROAD AS SHOWN ON SKETCH
ELEVATION = 125.65m

LOCAL BENCHMARK No. 2

TOP OF MANHOLE SOUTHEAST END ON MEADOWBROOK ROAD AS SHOWN ON SKETCH
ELEVATION = 123.64m

ELEVATIONS ON CURB ARE TAKEN FROM THE TOP.

IT IS THE RESPONSIBILITY OF THE CONTRACTOR TO VERIFY THAT THE LOCAL BENCHMARKS HAVE NOT BEEN ALTERED OR DISTURBED AND THAT THE RELATIVE ELEVATIONS AND DESCRIPTIONS AGREE WITH THE INFORMATION SHOWN ON THIS SKETCH.

BEFORE DIGGING, UNDERGROUND SERVICES SHOULD BE LOCATED ON SITE BY THE RESPECTIVE AGENCIES.

BOUNDARY DIMENSIONS SHOWN HERON ARE COMPILED FROM REGISTERED PLAN 1319, BEARINGS ROTATED TO MATCH UTM NAD83(CSRS) AND NOT FROM ACTUAL FIELD SURVEY

J.D.BARNES LIMITED
SURVEYING MAPPING GIS
LAND INFORMATION SPECIALISTS
401 WHEELABRATOR WAY, SUITE A, MILTON, ON L9T 5C1
T: (905) 875-9955 F: (905) 875-9956 www.jdbarnes.com

DRAWN BY:	CHECKED BY:	REFERENCE NO.:
CE		15-30-850-00-A
FILE: G:\15-30-850\00\53085000a.dgn		DATED: DECEMBER 14, 2015
		PLOTTED: 15/12/2015